


PREPARED BY:  
**DRAFTING & DESIGN**  
 Email: jmf@draftinganddesign.com Call: (432) 425-5297  
 AS-BUILT DRAWINGS FOR:  
**1900 WEST WALL STREET**  
 SUITE A & B  
 1900 N WALL  
 MIDLAND  
 TEXAS

Copyright © J.M. Drafting & Design  
 All rights reserved. No part of this drawing  
 may be reproduced, stored in a retrieval system,  
 or transmitted in any form or by any means  
 electronic, mechanical, photocopying, recording,  
 or by any information storage and retrieval  
 system, without the prior written permission  
 of J.M. Drafting & Design. This drawing is  
 intended for the specific project and site  
 conditions shown. It is not to be used for  
 any other project or site without the  
 express written permission of J.M. Drafting  
 & Design. Reproduction and distribution  
 without the express written permission of  
 J.M. Drafting & Design is prohibited.


DATE: SEPT. 02, 2020  
 DRAWN BY: jmf  
 JOB #: JM200062

**A** AS-BUILT FLOOR PLAN N.T.S.



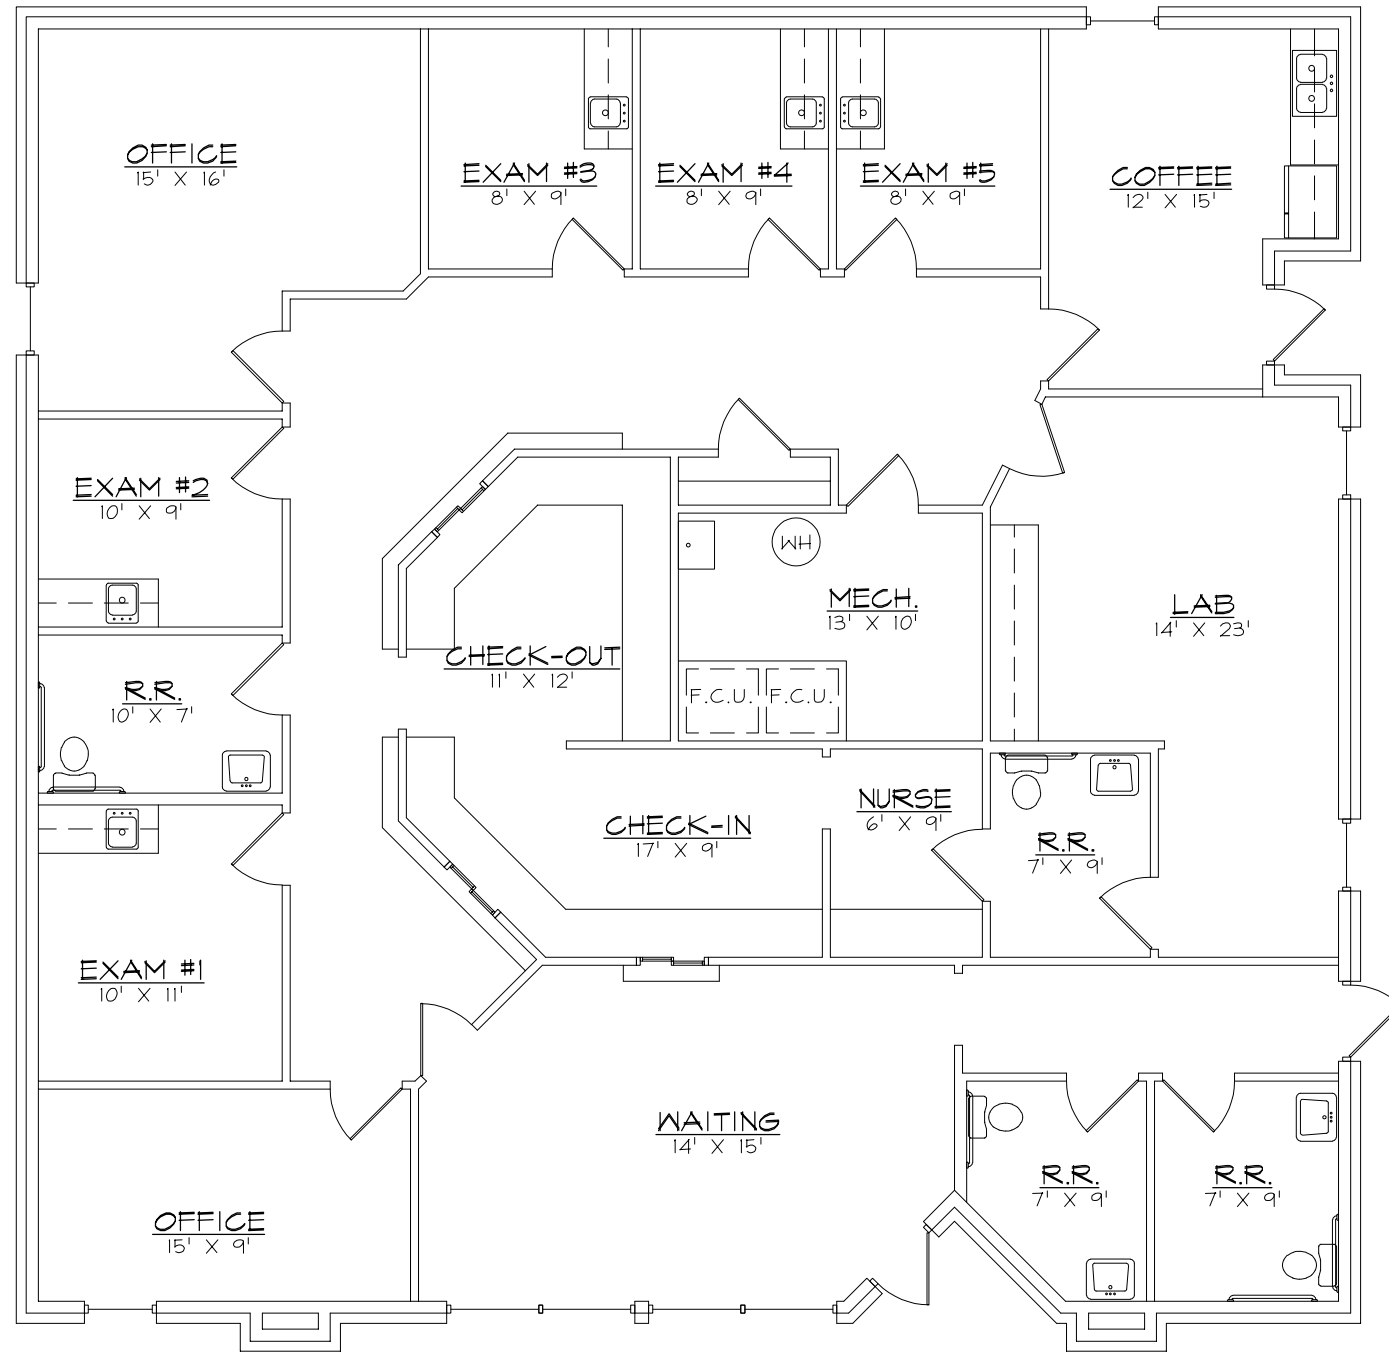

**A** FLOOR PLAN - BLD'G. "C"  
 3,071 SQ. FT. 1/8" = 1'-0"

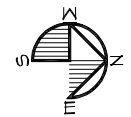

PREPARED BY:  
**J M DRAFTING & DESIGN**  
 Email: jmertink@gmail.com Cell: (432) 425-5297  
 NEW BUILDING FOR:  
**1900 WEST WALL STREET**  
 1900 W WALL  
 MIDLAND TEXAS

© COPYRIGHT, J M DRAFTING & DESIGN.  
 2020 FEDERAL COPYRIGHT PROTECTION  
 EXTENDING TO DERIVATIVE PLANS,  
 IS APPLICABLE TO INTENTIONAL AND  
 UNINTENTIONAL INFRINGEMENTS  
 AND PROVIDES FOR SPECIFIC  
 STATUTORY DAMAGES BOTH  
 CIVIL AND CRIMINAL. UNAUTHORIZED  
 REPRODUCTION IN ANY FORM IS  
 STRICTLY PROHIBITED AND FORBIDDEN.

DATE:  
 AUG. 31, 2020  
DWG2020/1900WestWall/1900WestWall-A1  
 JOB # JM20070