


ADDENDUM A FLOOR PLAN

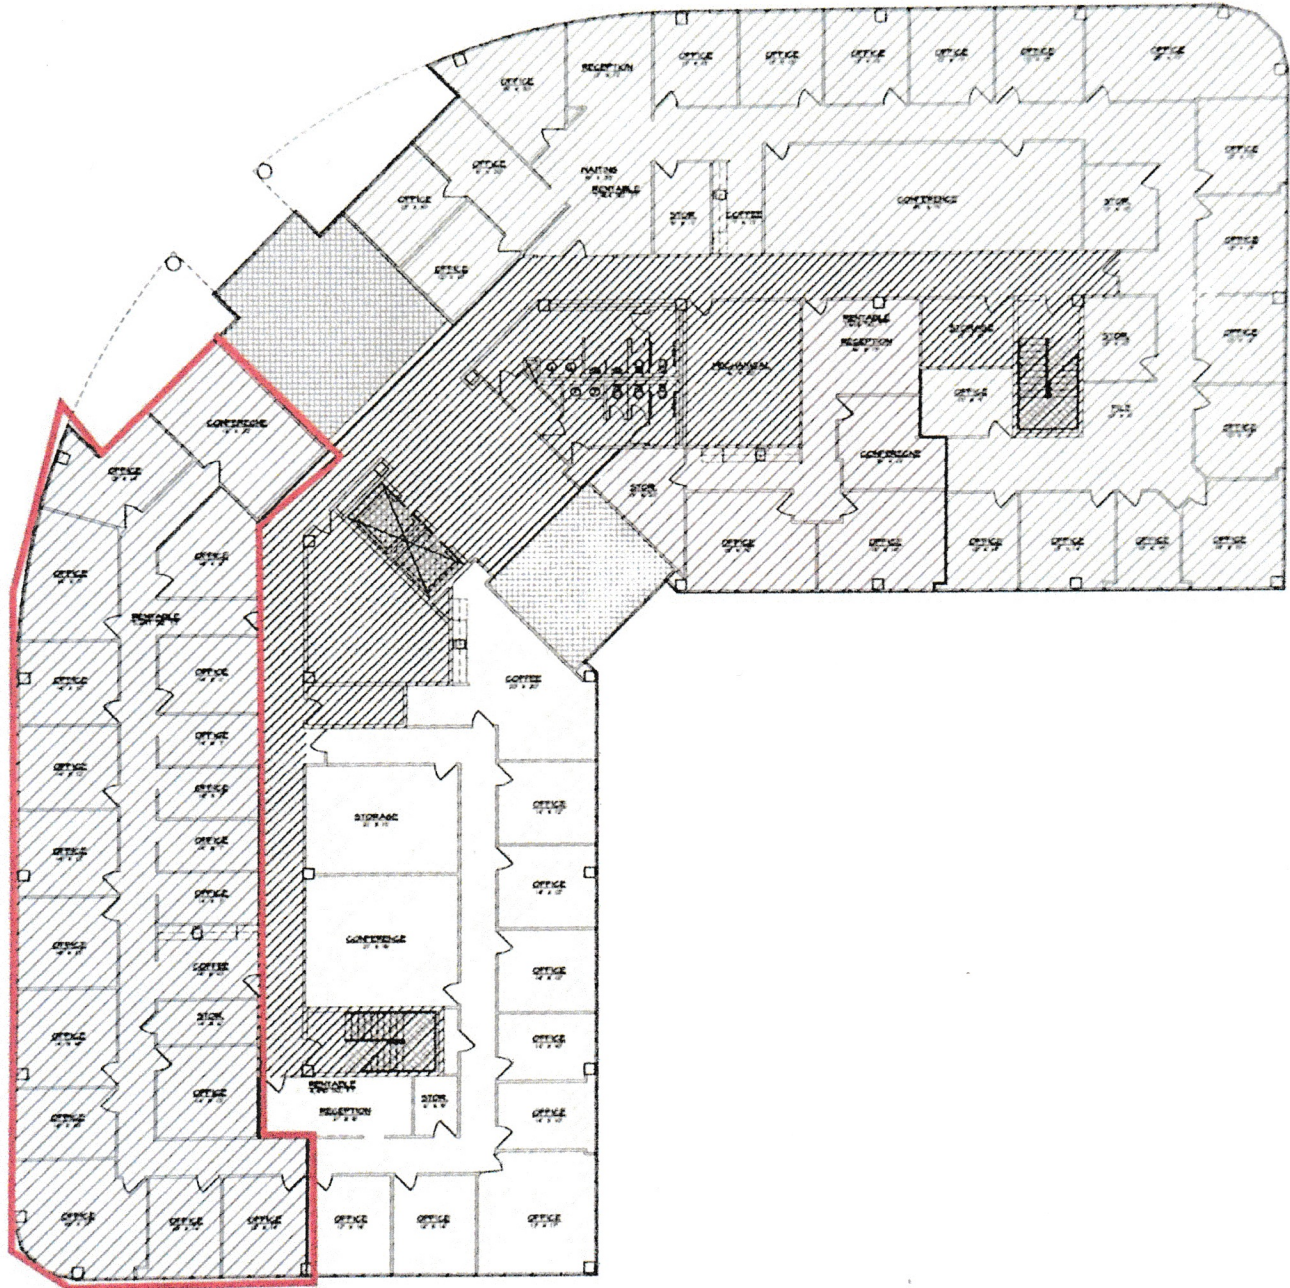


A 2ND FLOOR - FLOOR PLAN
SCALE N T S



Exhibit "B"

Existing Space

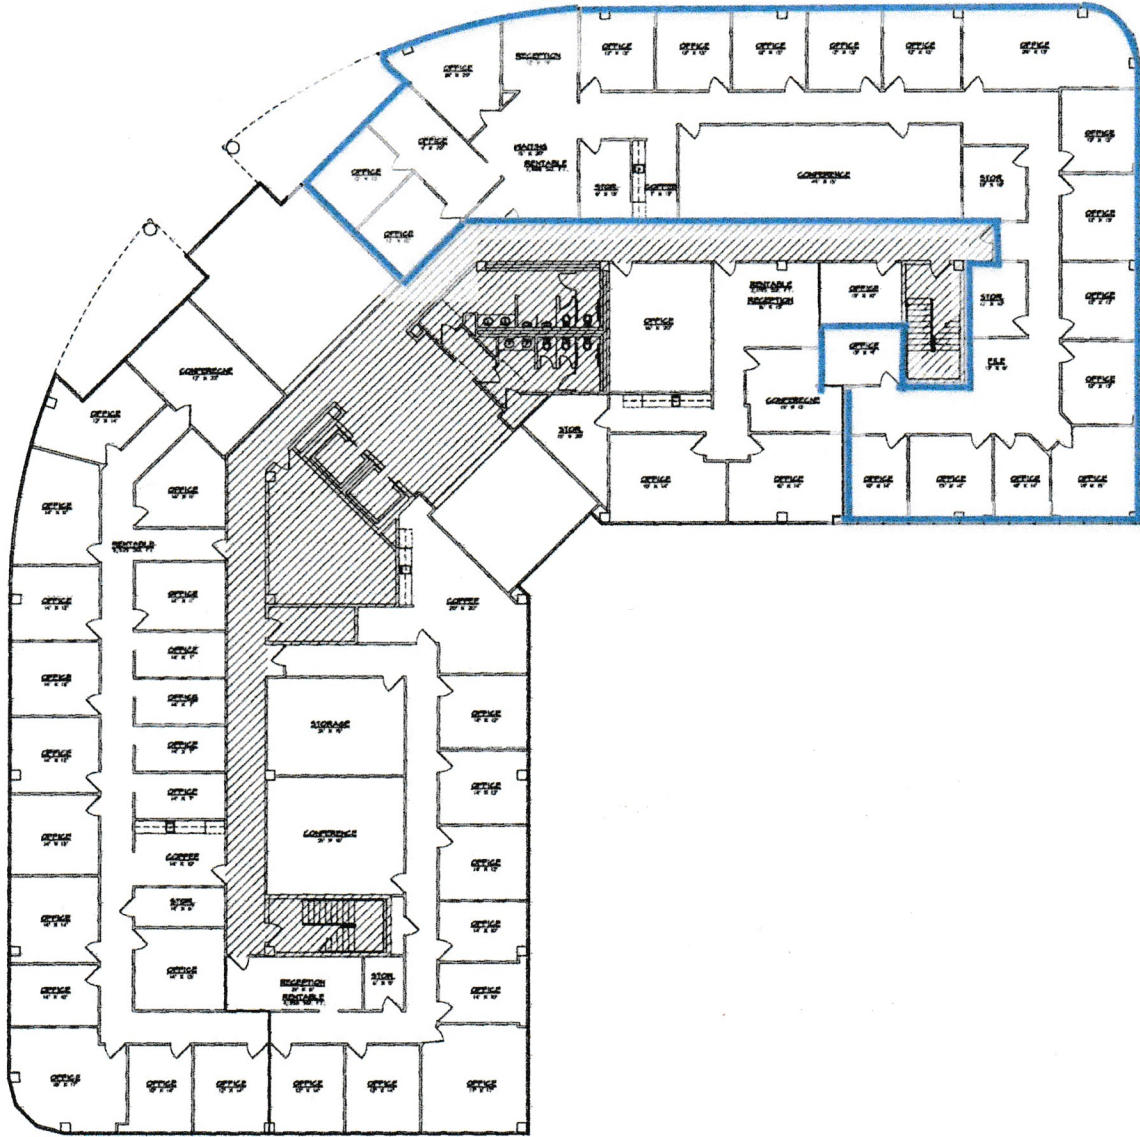

(A) 2ND FLOOR - FLOOR PLAN
SCALE N T S

PREPARED BY:
M DRAFTING & DESIGN
AS-BUILT DRAWINGS FOR:
4000 NORTH BIG SPRING
4000 NORTH BIG SPRING
MIDLAND TEXAS

© 2019 FEDERAL COPYRIGHT PROTECTION
COPYRIGHT, IN DRAWING & DESIGN
EXTENDING TO DERIVATIVE PLANS,
IS APPLICABLE TO INTENTIONAL AND
UNINTENTIONAL INFRINGEMENTS
AND PROVIDES FOR SPECIFIC
STATUTORY DAMAGES BOTH
CIVIL AND CRIMINAL. UNAUTHORIZED
REPRODUCTION IN ANY FORM IS
STRICTLY PROHIBITED AND FORBIDDEN

DATE:
FEB. 04, 2019
JCB - JTH 10/22