


A 2ND FLOOR - FLOOR PLAN
 SCALE N. T. S.

PREPARED BY:
J M DRAFTING & DESIGN
 AS-BUILT DRAWINGS FOR:
4000 NORTH BIG SPRING
 4000 NORTH BIG SPRING
 MIDLAND TEXAS

© 2019 FEDERAL COPYRIGHT PROTECTION
 COPYRIGHT, J M DRAFTING & DESIGN
 EXTENDING TO DERIVATIVE PLANS,
 IS APPLICABLE TO INTENTIONAL AND
 UNINTENTIONAL INFRINGEMENTS
 AND PROVIDES FOR SPECIFIC
 STATUTORY DAMAGES BOTH
 CIVIL AND CRIMINAL. UNAUTHORIZED
 REPRODUCTION IN ANY FORM IS
 STRICTLY PROHIBITED AND FORBIDDEN.

DATE:
 FEB. 04, 2019
 JOB # JM14052

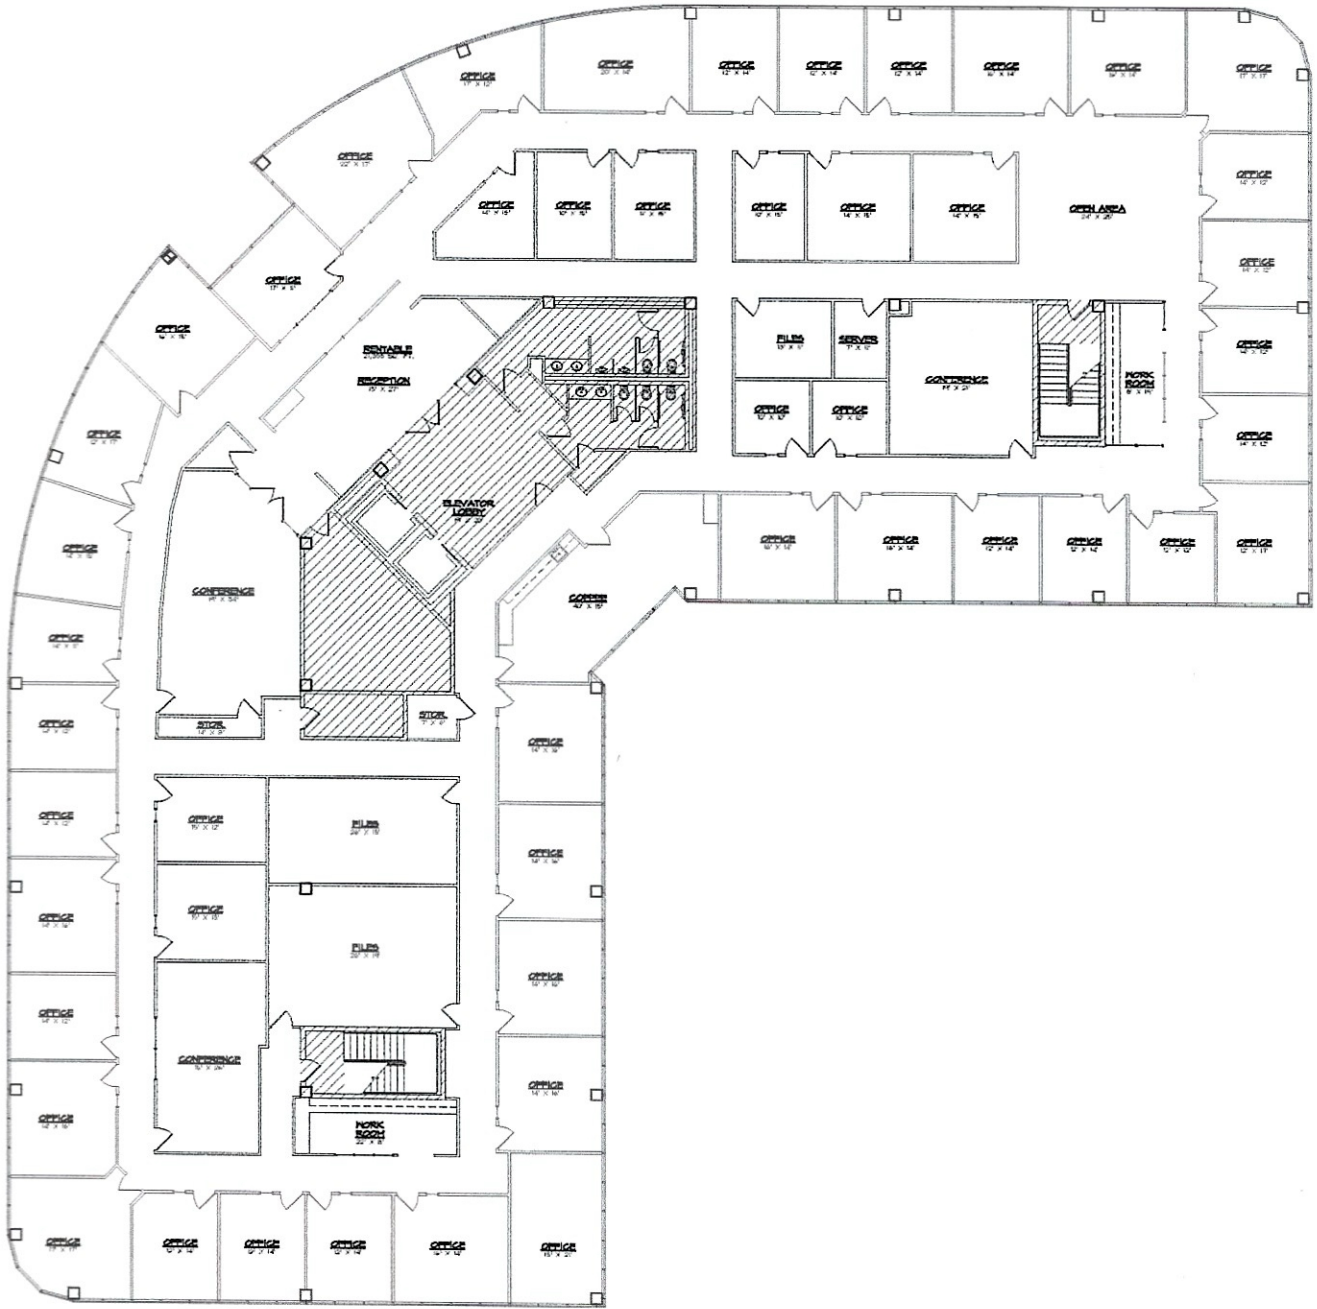

A 5TH FLOOR - FLOOR PLAN
SCALE N. T. S.



PREPARED BY:
J M DRAFTING & DESIGN
 AS-BUILT DRAWINGS FOR:

© 2013 FEDERAL COPYRIGHT PROTECTION
 COPYRIGHT, J M DRAFTING & DESIGN
 EXTENDING TO DERIVATIVE PLANS
 IS APPLICABLE TO INTENTIONAL AND
 UNINTENTIONAL INFRINGEMENTS