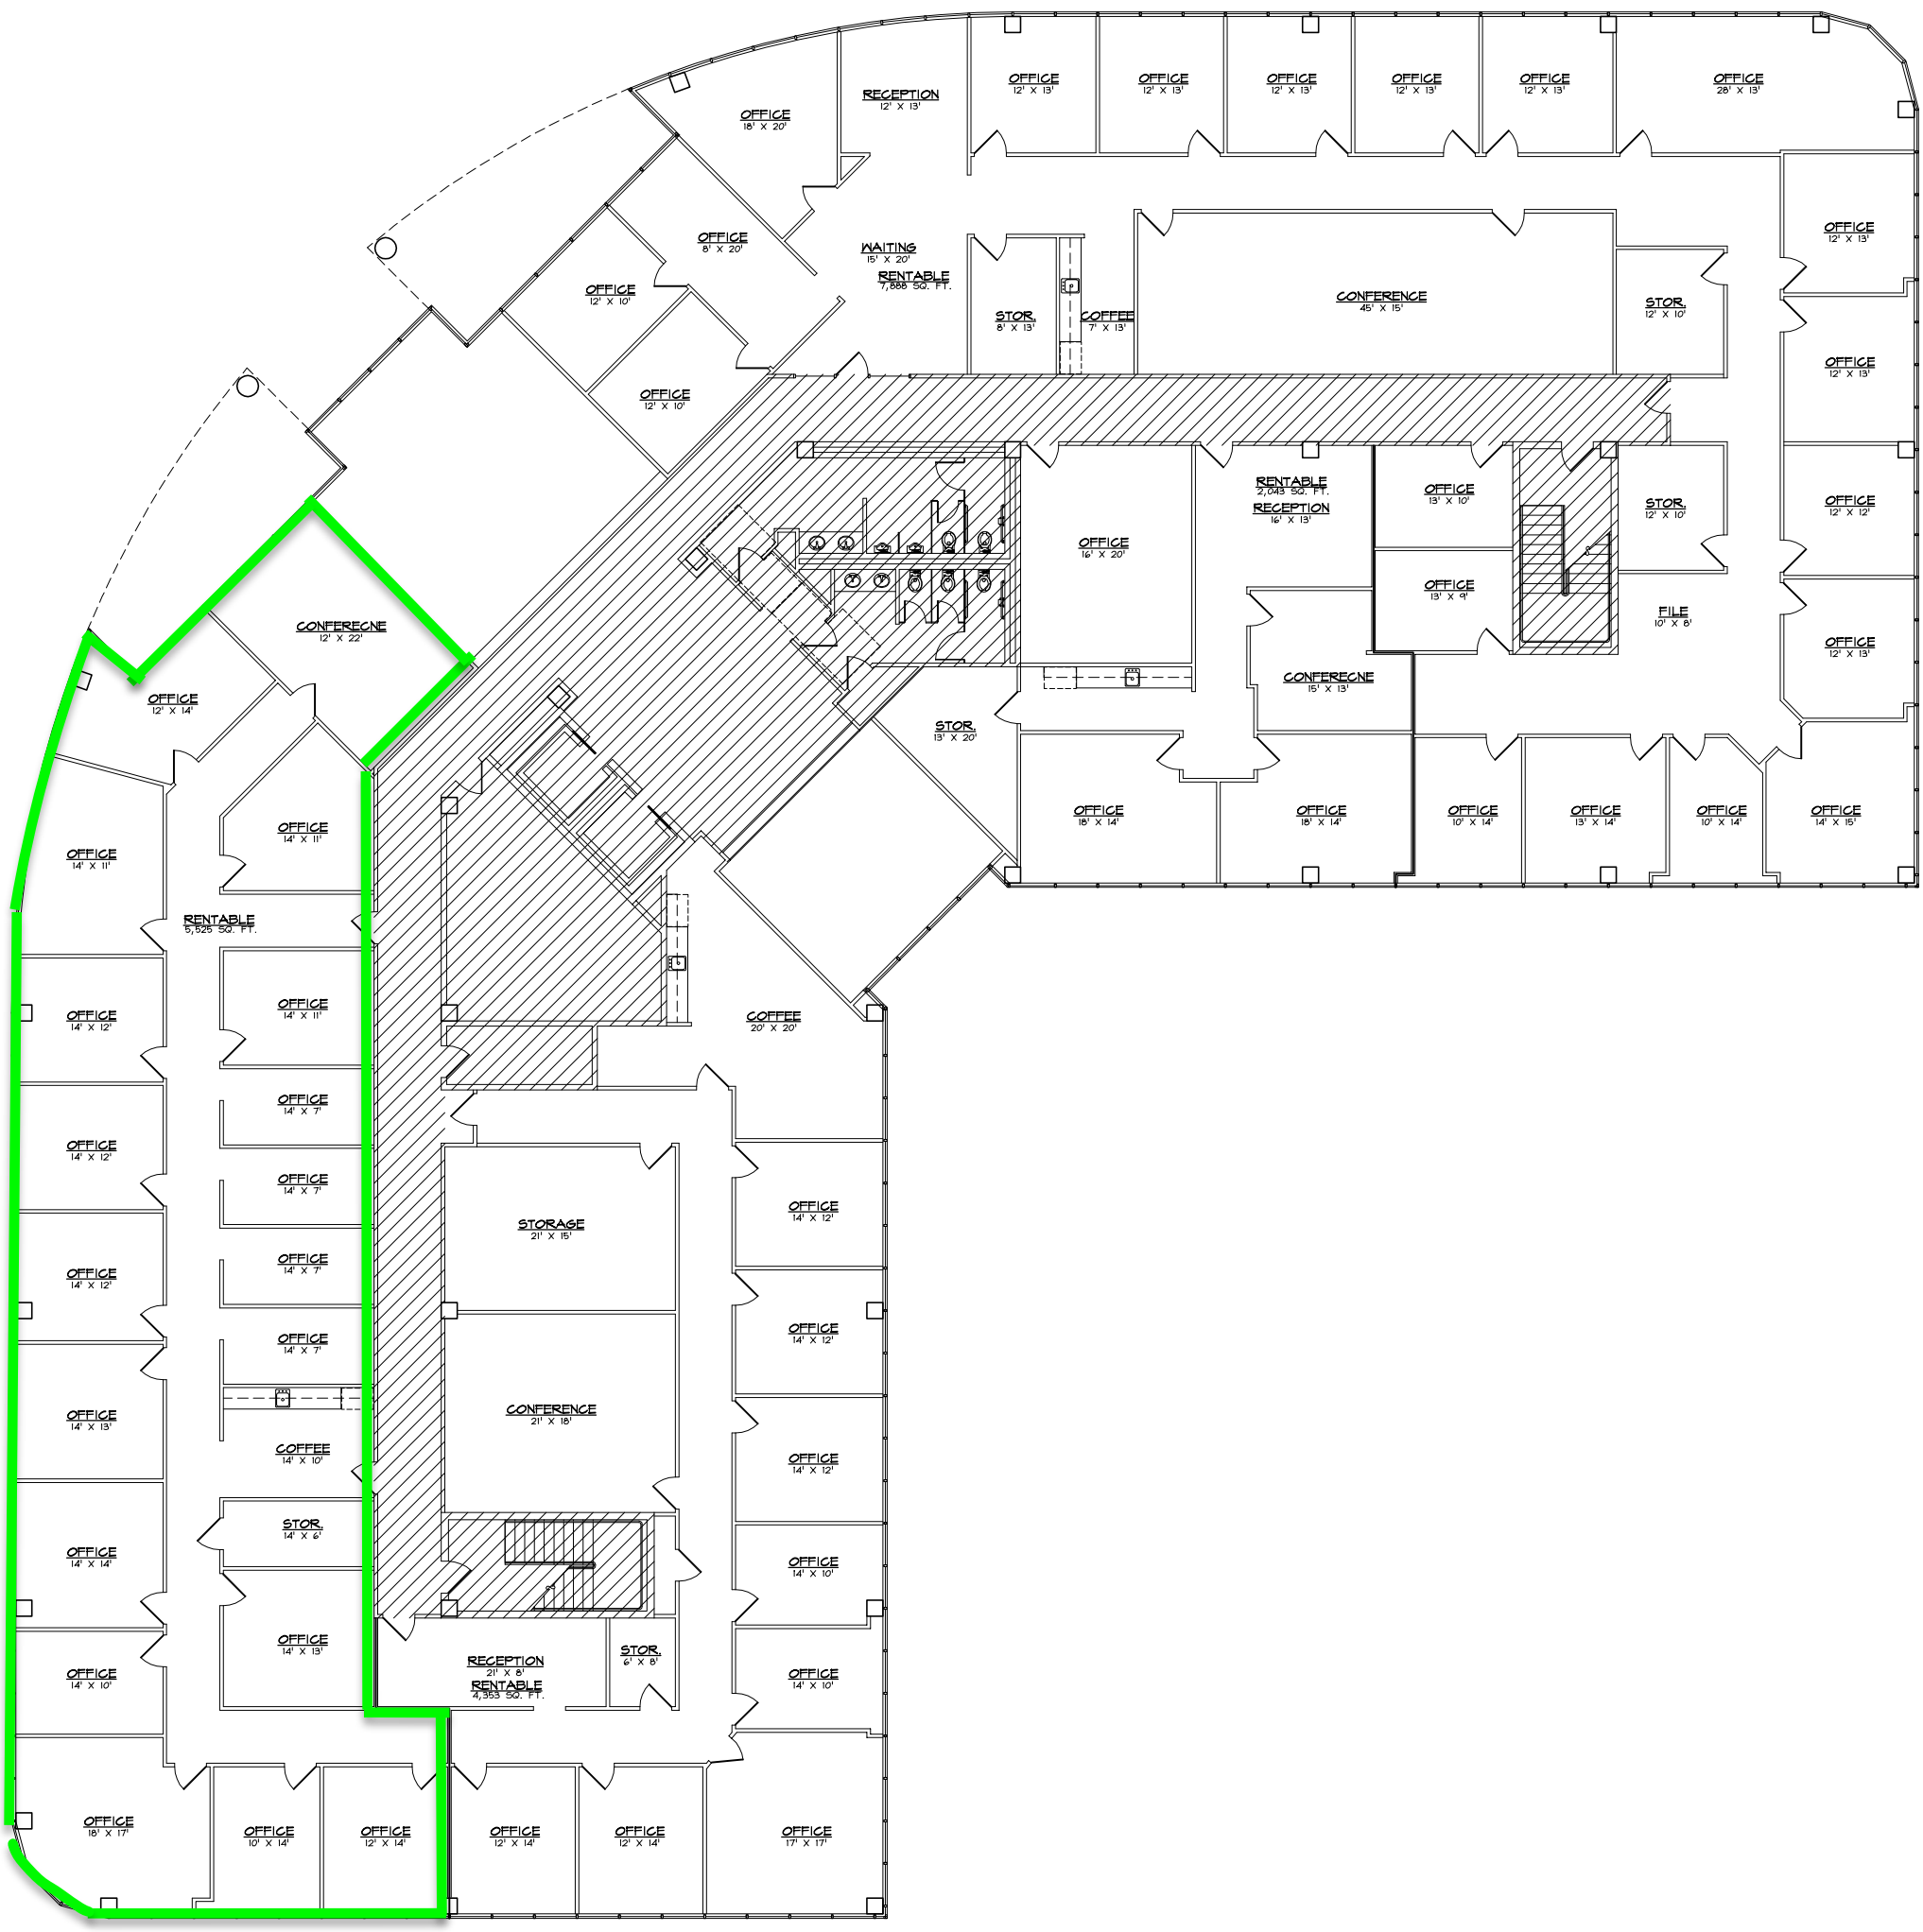

A 2ND FLOOR - FLOOR PLAN

SCALE N. T. S.

PREPARED BY:
DRAFTING & DESIGN

AS-BUILT DRAWINGS FOR:
4000 NORTH BIG SPRING
4000 NORTH BIG SPRING
MIDLAND TEXAS

© 2019 FEDERAL COPYRIGHT PROTECTION COPYRIGHT, J M DRAFTING & DESIGN EXTENDING TO DERIVATIVE PLANS, IS APPLICABLE TO INTENTIONAL AND UNINTENTIONAL INFRINGEMENTS AND PROVIDES FOR SPECIFIC STATUTORY DAMAGES BOTH CIVIL AND CRIMINAL. UNAUTHORIZED REPRODUCTION IN ANY FORM IS STRICTLY PROHIBITED AND FORBIDDEN.

DATE:
FEB. 04, 2019
DWG2019/ThisRealty/4000NBigSpring/4000BigSpring
JOB # JM19032