"AS BUILT" SURVEY

COPYRIGHT 2018
This survey plat is being provided solely for the use of: Mark Mays & West Texas Abstract & Title Co., and that no license has been created, express or implied, to copy the survey plat except as is necessary in conjunction with the original transaction dated March 8, 2018, which shall take place within 90 days after the survey was provided.

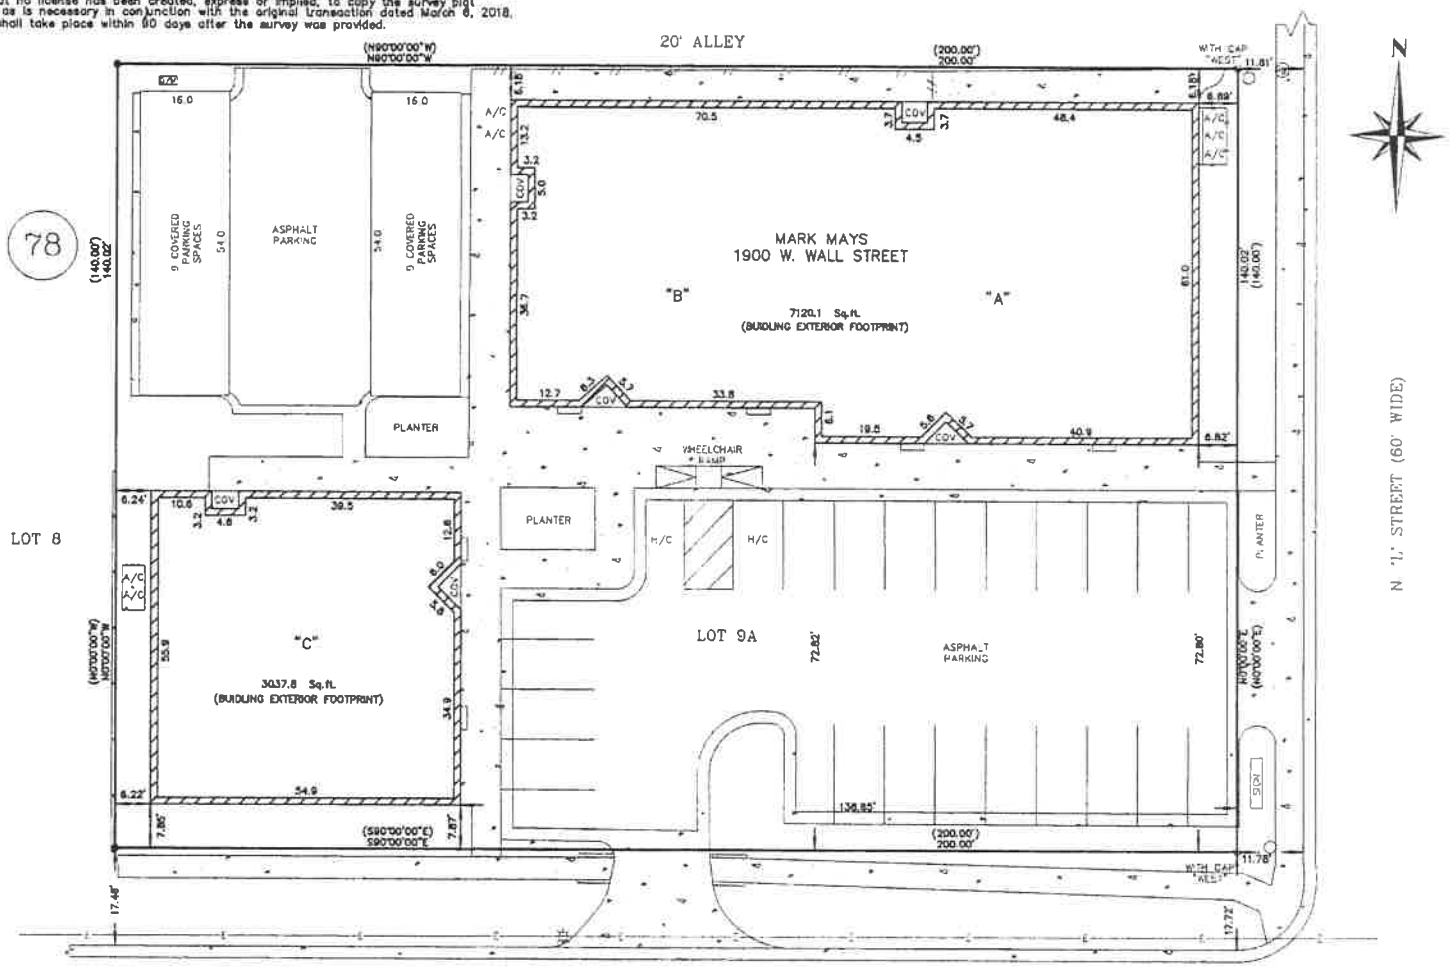

Census Tract: 11

This tract is in Flood Zone "X" as shown on the Flood Insurance Rate Map, Dated September 16, 2005 provided by the Federal Emergency Management Agency Flood Map Number: 48329C0201 F

The undersigned does hereby certify that this survey was this day made on the ground of the property legally described hereon and is correct, and that there are no visible discrepancies, conflicts, shortages in area, boundary line conflicts, encroachments, overlapping of improvements, easements or rights-of-way, except as shown hereon, and that said property has access to and from a dedicated roadway.

Dated this the 9th day of March 2018

Registered Professional Land Surveyor No. 4170
Date: 03/09/18

(IF SURVEYORS SIGNATURE IS NOT SIGNED IN RED INK, THIS IS NOT AN ORIGINAL DOCUMENT)

PENNELL LAND SURVEYING
PROFESSIONAL LAND SURVEYING
P.O. BOX 51622, MIDLAND, TEXAS 79710
VOICE:(432)570-6256 FAX. (432)682-3262 MOBILE: (432)528-1027

ABSTRACT OFFICE: WEST TEXAS	G.F. # 4680180366J	COMMITMENT EFFECTIVE DATE: 02/07/18
CAD FILE: BRP20026	DATA FILE: 1900WALL	DRAWN BY: MARCY H. BOOK/PAGE: 1/

STATE OF TEXAS REGISTERED BRUCE R. PENNELL 4170 PROFESSIONAL LAND SURVEYOR

SURVEY OF
LOT NINE A (9A), BLOCK SEVENTY EIGHT (78),
WEST END ADDITION, SECTION 14,
A REPLAT OF LOTS 9-12, BLOCK 78, WEST END ADDITION,
(ACCORDING TO THE MAP OR PLAT THEREOF, RECORDED IN CABINET E, PAGE 52, PLAT RECORDS, MIDLAND COUNTY, TEXAS)
AN ADDITION TO THE CITY OF MIDLAND
MIDLAND COUNTY, TEXAS
ACCORDING TO THE MAP OR PLAT THEREOF, RECORDED IN CABINET H, PAGE 27, PLAT RECORDS, MIDLAND COUNTY, TEXAS

Basis of Bearings
EAST Line of this Lot

Bearings and Distances Shown
Inside ( ) Indicate Record Information

20 10 0 20

SCALE: 1" = 20'

18 COVERED PARKING SPACES
23 PARKING SPACES
2 HANDICAPED PARKING SPACES

LEGEND

- Set 1/2" I.R W/Cap "RPLS 4170"
- O Fnd 1/2" I.R
- G.M Gas Meter
- Water Meter
- Light Pole
- E E OVERHEAD ELECTRIC
- Misc. Sign
- SW Southwestern Bell Manhole