



**4000 N. Big Spring Street | Midland, TX 79705**

**Dub House, MAI, CCIM, Broker**

dubhouse@thisrealty.com

432.570.0705

[www.thisrealty.com](http://www.thisrealty.com)

# Executive Summary

Suites are available for lease in this office building with recent updates to tenant space/common areas, and open and covered parking included. The possibility exists to relocate tenants should a client need a full floor space in the building.

## Highlights:

- Numerous updates to tenant space and common areas
- Open and covered parking at no additional charge

Schedule a tour today or view it virtually on our website.

*\*This property is listed as unpriced - price is available upon request, just not on a public forum.*

# Map



4000 N. Big Spring Street | Midland, TX 79705

this **Realty**

# Aerial View



4000 N. Big Spring Street | Midland, TX 79705

this **Realty**

# 1st Floor Plan



① 1ST FLOOR - FLOOR PLAN  
SCALE \_\_\_\_\_ N. T. S. 

PREPARED BY:  
**M** DRAFTING & DESIGN  
AS-BUILT DRAWINGS FOR:  
**4000 NORTH BIG SPRING**  
4000 NORTH BIG SPRING  

© 2018 FEDERAL COPYRIGHT PROTECTED  
COPYRIGHT 2018 DRAFTING & DESIGN  
RETURNING TO DRAFTING & DESIGN  
BY ANY MEANS, ELECTRONIC OR MECHANICAL,  
INCLUDING PHOTOCOPYING, RECORDING,  
OR BY ANY INFORMATION STORAGE AND  
RETRIEVAL SYSTEM, WITHOUT PERMISSION  
IN WRITING FROM DRAFTING & DESIGN  
IS STRICTLY PROHIBITED AND UNLAWFUL.

DATE:  
FEB. 04, 2018  
BY: [Signature]

# 2nd Floor Plan



(A) 2ND FLOOR - FLOOR PLAN  
SCALE: N.T.S.


PREPARED BY:  

**M DRAFTING & DESIGN**  
 AS-BUILT DRAWINGS FOR:  
**4000 NORTH BIG SPRING**  
 MIDLAND TEXAS



# 5th Floor Plan

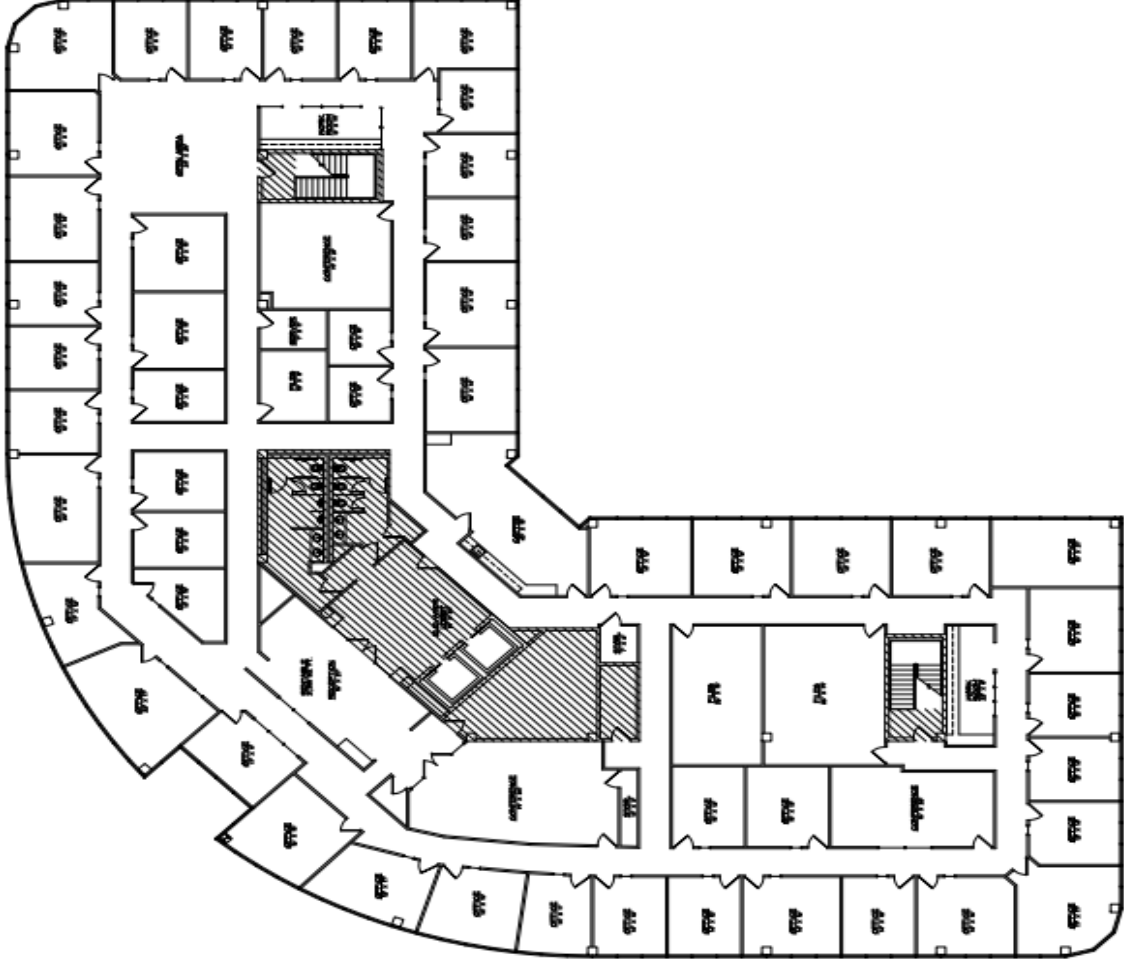


**A** 5TH FLOOR - FLOOR PLAN  L.T.S.




DATE: FEB. 04, 2009  
 DRAWN BY: JPH/MS

PREPARED BY:  
**M DRAFTING & DESIGN**  
 AS-BUILT DRAWINGS FOR:  
**4000 NORTH BIG SPRING**  

# Survey

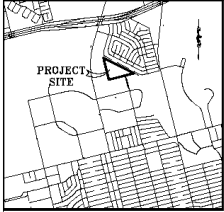

VICINITY MAP  
(SCALE)

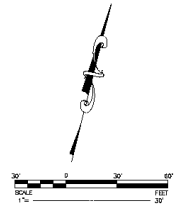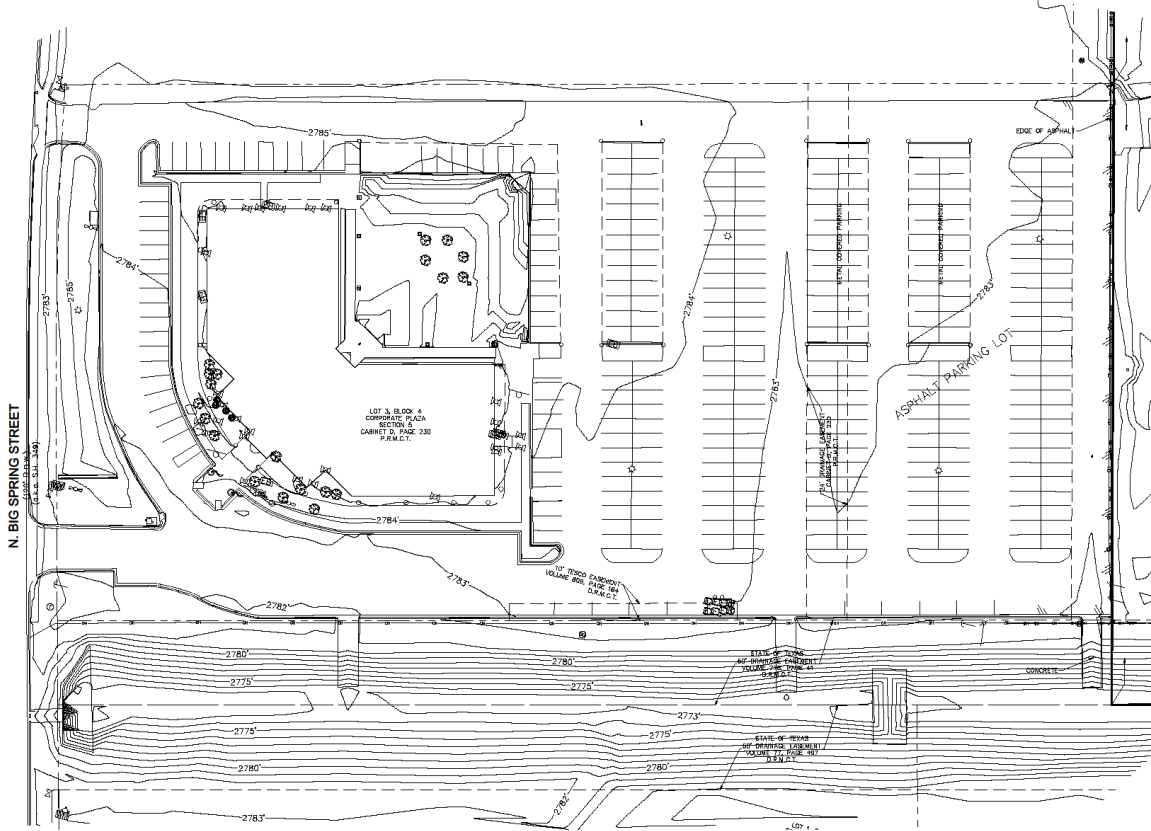

- LEGEND**
- PA.M.C.T. = PLAT RECORDS MIDLAND COUNTY, TEXAS
  - P.A.M.C.T. = PLAT RECORDS MIDLAND COUNTY, TEXAS
  - DA = CONTROLING MONUMENT
  - ( ) = DEED CALL
  - ⊕ = SANITARY SEWER MANHOLE
  - = GUY WIRE
  - ⊞ = GAS METER







## Information About Brokerage Services

Texas law requires all real estate licensees to give the following information about brokerage services to prospective buyers, tenants, sellers and landlords.

### TYPES OF REAL ESTATE LICENSE HOLDERS:

- # A **BROKER** is responsible for all brokerage activities, including acts performed by sales agents sponsored by the broker.
- # A **SALES AGENT** must be sponsored by a broker and works with clients on behalf of the broker.

### A BROKER'S MINIMUM DUTIES REQUIRED BY LAW (A client is the person or party that the broker represents):

- # Put the interests of the client above all others, including the broker's own interests;
- # Inform the client of any material information about the property or transaction received by the broker;
- # Answer the client's questions and present any offer to or counter-offer from the client; and
- # Treat all parties to a real estate transaction honestly and fairly.

### A LICENSE HOLDER CAN REPRESENT A PARTY IN A REAL ESTATE TRANSACTION:

**AS AGENT FOR OWNER (SELLER/LANDLORD):** The broker becomes the property owner's agent through an agreement with the owner, usually in a written listing to sell or property management agreement. An owner's agent must perform the broker's minimum duties above and must inform the owner of any material information about the property or transaction known by the agent, including information disclosed to the agent or subagent by the buyer or buyer's agent.

**AS AGENT FOR BUYER/TENANT:** The broker becomes the buyer/tenant's agent by agreeing to represent the buyer, usually through a written representation agreement. A buyer's agent must perform the broker's minimum duties above and must inform the buyer of any material information about the property or transaction known by the agent, including information disclosed to the agent by the seller or seller's agent.

**AS AGENT FOR BOTH - INTERMEDIARY:** To act as an intermediary between the parties the broker must first obtain the written agreement of each party to the transaction. The written agreement must state who will pay the broker and, in conspicuous bold or underlined print, set forth the broker's obligations as an intermediary. A broker who acts as an intermediary:

- # Must treat all parties to the transaction impartially and fairly;
- # May, with the parties' written consent, appoint a different license holder associated with the broker to each party (owner and buyer) to communicate with, provide opinions and advice to, and carry out the instructions of each party to the transaction.
- # Must not, unless specifically authorized in writing to do so by the party, disclose:
  - o that the owner will accept a price less than the written asking price;
  - o that the buyer/tenant will pay a price greater than the price submitted in a written offer; and
  - o any coincidental information or any other information that a party specifically instructs the broker in writing not to disclose, unless required to do so by law.

**AS SUBAGENT:** A license holder acts as a subagent when aiding a buyer in a transaction without an agreement to represent the buyer. A subagent can assist the buyer but does not represent the buyer and must place the interests of the owner first.

### TO AVOID DISPUTES, ALL AGREEMENTS BETWEEN YOU AND A BROKER SHOULD BE IN WRITING AND CLEARLY ESTABLISH:

- # The broker's duties and responsibilities to you, and your obligations under the representation agreement.
- # Who will pay the broker for services provided to you, when payment will be made and how the payment will be calculated.

**LICENSE HOLDER CONTACT INFORMATION:** This notice is being provided for information purposes. It does not create an obligation for you to use the broker's services. Please acknowledge receipt of this notice below and retain a copy for your records.

<u>Zero Five Two Two Eight Two, Inc</u>	<u>479486</u>	<u>dubhouse@thisrealty.com</u>	<u>(432)570-0705</u>
Licensed Broker /Broker Firm Name or Primary Assumed Business Name	License No.	Email	Phone
<u>d/b/a thisRealty</u>	<u>479486</u>	<u>dubhouse@thisrealty.com</u>	<u>(432)570-0705</u>
Designated Broker of Firm	License No.	Email	Phone
<u>Winfred B House</u>	<u>296610</u>	<u>dubhouse@thisrealty.com</u>	<u>(432)570-0705</u>
Licensed Supervisor of Sales Agent/ Associate	License No.	Email	Phone
_____	_____	_____	_____
Sales Agent/Associate's Name	License No.	Email	Phone

\_\_\_\_\_  
Buyer/Tenant/Seller/Landlord Initials

\_\_\_\_\_  
Date

Regulated by the Texas Real Estate Commission

Information available at [www.trec.texas.gov](http://www.trec.texas.gov)  
IABS 1-0

# The Sign You've Seen Around Town is the Sign You've Come to Trust

thisRealty is a locally owned and operated real estate firm with a 40+ year history in West Texas. We are composed of seasoned realty agents that specialize in assisting our clients in buying, selling and leasing commercial real estate.

this **Realty**