



4000 N. Big Spring Street | Midland, TX 79705

Dub House, MAI, CCIM, Broker

dubhouse@thisrealty.com

432.570.0705

www.thisrealty.com

Executive Summary

Suites are available for lease in this office building with recent updates to tenant space/common areas, and open and covered parking included. The possibility exists to relocate tenants should a client need a full floor space in the building.

Highlights:

- Numerous updates to tenant space and common areas
- Open and covered parking at no additional charge

Schedule a tour today or view it virtually on our website.

**This property is listed as unpriced - price is available upon request, just not on a public forum.*

Map



4000 N. Big Spring Street | Midland, TX 79705

this **Realty**

Aerial View




ALL PROPERTY LINES ARE APPROXIMATE & NOT SURVEY ACCURATE.

4000 N. Big Spring Street | Midland, TX 79705

this **Realty**

2nd Floor Plan

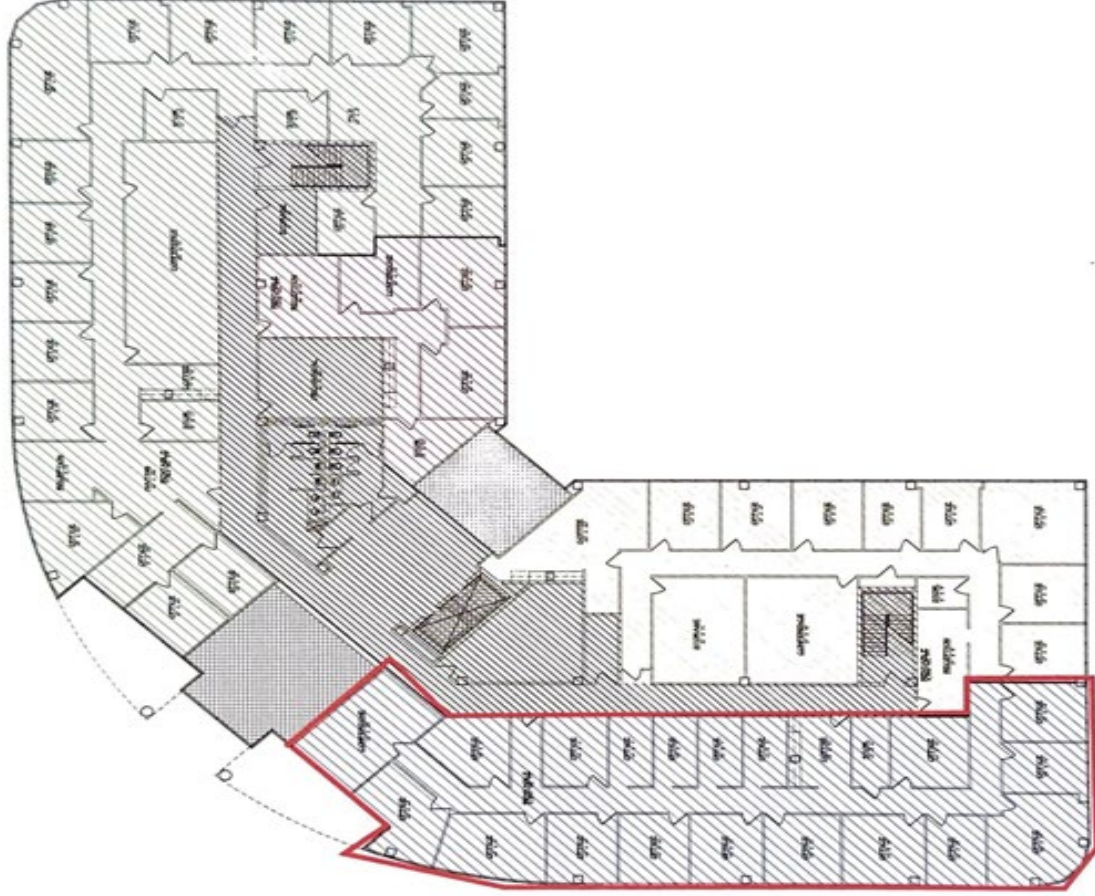


A 2ND FLOOR - FLOOR PLAN  S.T.S.

PREPARED BY:
M DRAFTING & DESIGN
 www.mdrafting.com Call (407) 426-3201
 FOOTAGE CALCULATIONS FOR:
SECOND FLOOR
 4000 NORTH DUS SPRING

© COPYRIGHT, IN DRAWING & DESIGN

DATE
 OCT. 0, 2023
 JOB # 202302

5th Floor Plan

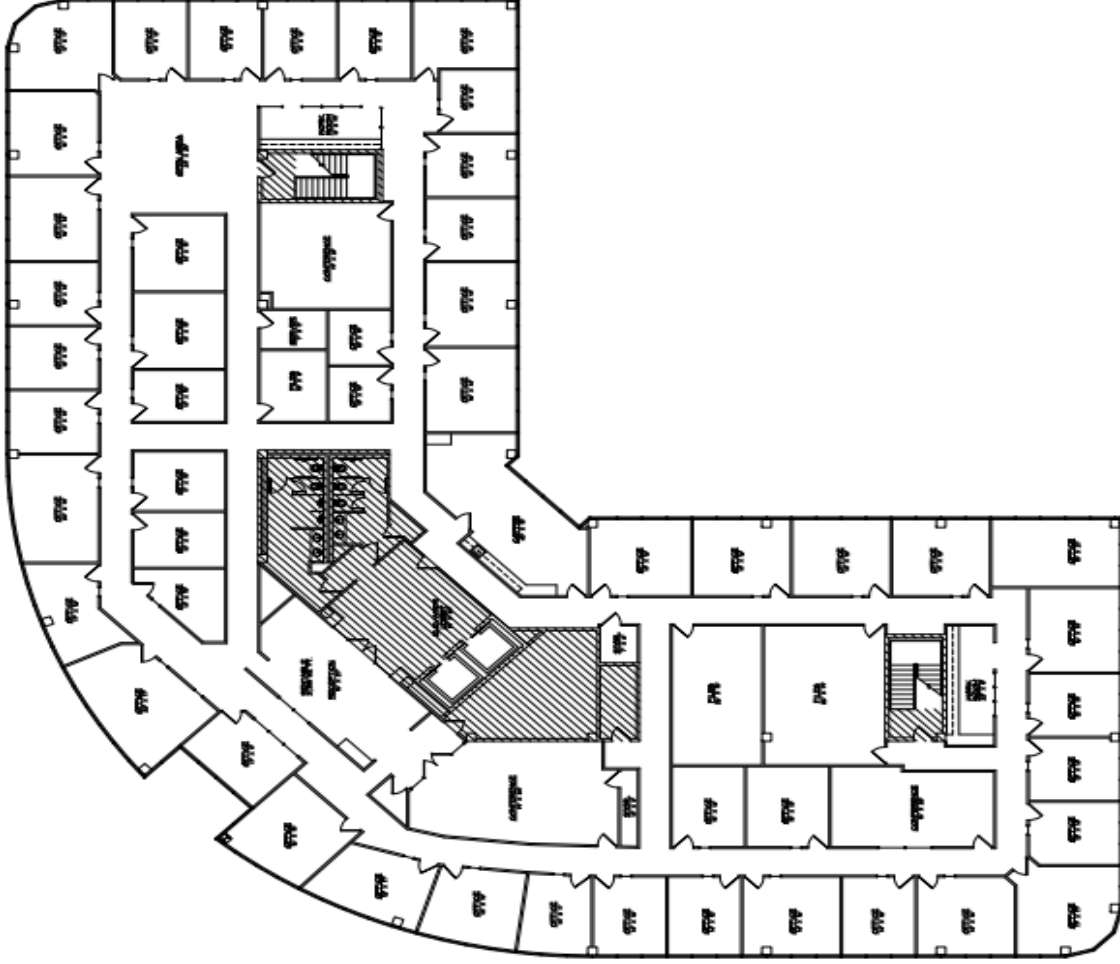

A 5TH FLOOR - FLOOR PLAN L.T.S.


DATE: FEB. 04, 2009
 DRAWN BY: JPH/MS

PREPARED BY:
M DRAFTING & DESIGN
 AS-BUILT DRAWINGS FOR:
4000 NORTH BIG SPRING
 HOLLAND TEXAS



Information About Brokerage Services

Texas law requires all real estate license holders to give the following information about brokerage services to prospective buyers, tenants, sellers and landlords.

11-03-2025



The Sign You've Seen Around Town is the Sign You've Come to Trust

thisRealty is a locally owned and operated real estate firm with a 40+ year history in West Texas. We are composed of seasoned realty agents that specialize in assisting our clients in buying, selling and leasing commercial real estate.



TYPES OF REAL ESTATE LICENSE HOLDERS:

- A **BROKER** is responsible for all brokerage activities, including acts performed by sales agents sponsored by the broker.
- A **SALES AGENT** must be sponsored by a broker and works with clients on behalf of the broker.

A BROKER'S MINIMUM DUTIES REQUIRED BY LAW (A client is the person or party that the broker represents):

- Put the interests of the client above all others, including the broker's own interests;
- Inform the client of any material information about the property or transaction received by the broker;
- Answer the client's questions and present any offer to or counter-offer from the client; and
- Treat all parties to a real estate transaction honestly and fairly.

WRITTEN AGREEMENTS ARE REQUIRED IN CERTAIN SITUATIONS: A license holder who performs brokerage activity for a prospective buyer of residential property must enter into a written agreement with the buyer before showing any residential property to the buyer or if no residential property will be shown, before presenting an offer on behalf of the buyer. This written agreement must contain specific information required by Texas law. For more information on these requirements, see section 1101.563 of the Texas Occupations Code. **Even if a written agreement is not required, to avoid disputes, all agreements between you and a broker should be in writing and clearly establish: (i) the broker's duties and responsibilities to you and your obligations under the agreement; and (ii) the amount or rate of compensation the broker will receive and how this amount is determined.**

A LICENSE HOLDER CAN REPRESENT A PARTY IN A REAL ESTATE TRANSACTION:

AS AGENT FOR OWNER (SELLER/LANDLORD): The broker becomes the property owner's agent through an agreement with the owner, usually in a written listing to sell or property management agreement. An owner's agent must perform the broker's minimum duties above and must inform the owner of any material information about the property or transaction known by the agent, including information disclosed to the agent by the buyer or buyer's agent. **An owner's agent fees are not set by law and are fully negotiable.**

AS AGENT FOR BUYER/TENANT: The broker becomes the buyer/tenant's agent by agreeing to represent the buyer, usually through a written representation agreement. A buyer's agent must perform the broker's minimum duties above and must inform the buyer of any material information about the property or transaction known by the agent, including information disclosed to the agent by the seller or seller's agent. **A buyer/tenant's agent fees are not set by law and are fully negotiable.**

AS AGENT FOR BOTH - INTERMEDIARY: To act as an intermediary between the parties the broker must first obtain the written agreement of each party to the transaction. The written agreement must state who will pay the broker and, in conspicuous bold or underlined print, set forth the broker's obligations as an intermediary. A broker who acts as an intermediary:

- Must treat all parties to the transaction impartially and fairly;
- May, with the parties' written consent, appoint a different license holder associated with the broker to each party (owner and buyer) to communicate with, provide opinions and advice to, and carry out the instructions of each party to the transaction.
- Must not, unless specifically authorized in writing to do so by the party, disclose:
 - o that the owner will accept a price less than the written asking price;
 - o that the buyer/tenant will pay a price greater than the price submitted in a written offer; and
 - o any confidential information or any other information that a party specifically instructs the broker in writing not to disclose, unless required to do so by law.

A LICENSE HOLDER CAN SHOW PROPERTY TO A BUYER/TENANT WITHOUT REPRESENTING THE BUYER/TENANT IF:

- The broker has not agreed with the buyer/tenant, either orally or in writing, to represent the buyer/tenant;
- The broker is not otherwise acting as the buyer/tenant's agent at the time of showing the property;
- The broker does not provide the buyer/tenant opinions or advice regarding the property or real estate transactions generally; and
- The broker does not perform any other act of real estate brokerage for the buyer/tenant.

Before showing a residential property to an unrepresented prospective buyer, a license holder must enter into a written agreement that contains the information required by section 1101.563 of the Texas Occupations Code. The agreement may not be exclusive and must be limited to no more than 14 days.

LICENSE HOLDER CONTACT INFORMATION: This notice is being provided for information purposes. It does not create an obligation for you to use the broker's services. Please acknowledge receipt of this notice below and retain a copy for your records.

Zero Five Two Two Eight Two, Inc	479486	dubhouse@thisrealty.com	(432)570-0705
Name of Sponsoring Broker (Licensed Individual or Business Entity)	License No.	Email	Phone
d/b/a thisRealty	479486	dubhouse@thisrealty.com	(432)570-0705
Name of Designated Broker of Licensed Business Entity, if applicable	License No.	Email	Phone
WB House	296610	dubhouse@thisrealty.com	(432)570-0705
Name of Licensed Supervisor of Sales Agent/Associate, if applicable	License No.	Email	Phone
Name of Sales Agent/Associate	License No.	Email	Phone

Buyer/Tenant/Seller/Landlord Initials

Date

Regulated by the Texas Real Estate Commission

Information available at www.trec.texas.gov

IABS 1-2

thisRealty, P.O. Box 7413 Midland TX 79708
WB House

Produced with Lone Wolf Transactions (zipForm Edition) 717 N Harwood St, Suite 2200, Dallas, TX 75201

Phone: 4325700705 Fax: (432) 682-4992

www.lwolf.com

SCR 1276