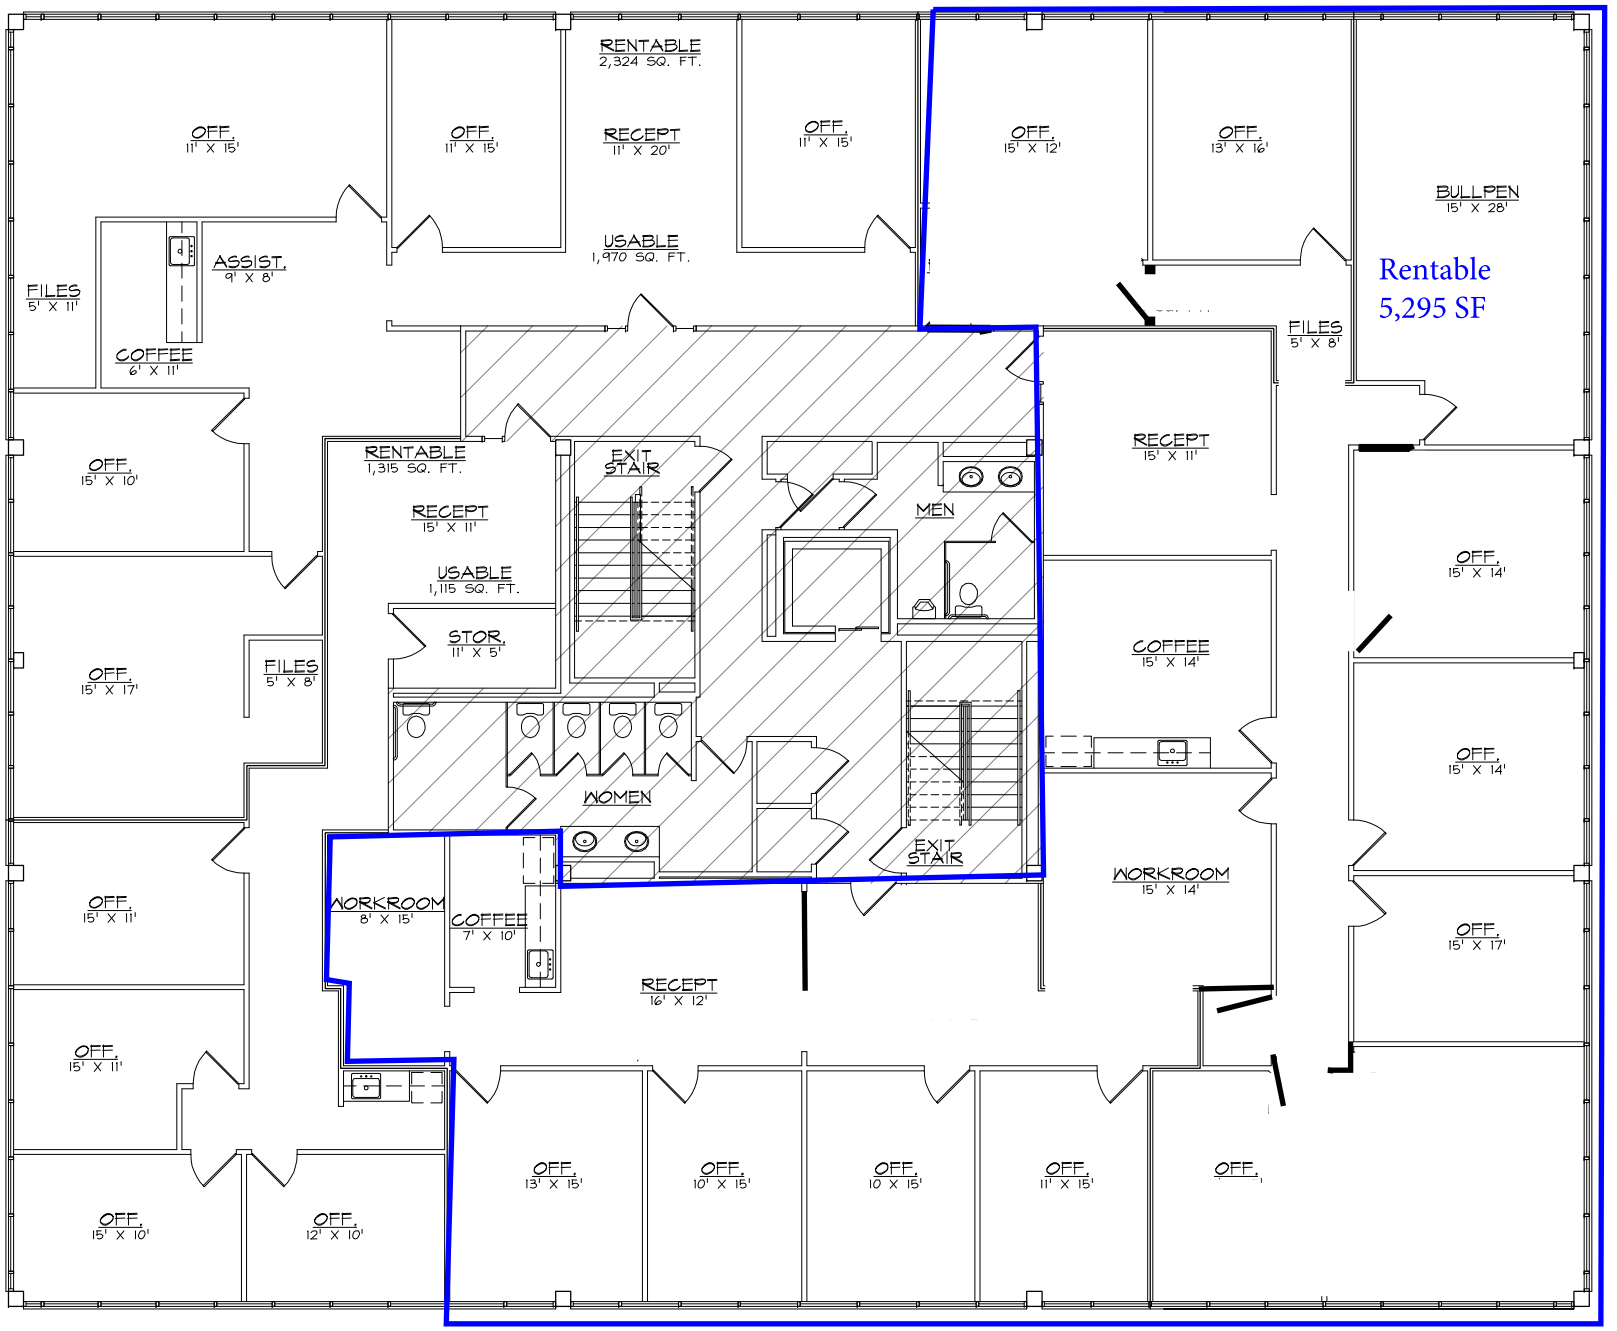

A AS-BUILT FLOOR PLAN
SECOND FLOOR
1/8" = 1'-0"

© 2018 FEDERAL COPYRIGHT PROTECTION
COPYRIGHT, THIS DRAFTING & DESIGN
IS APPLICABLE TO INTENTIONAL AND
UNINTENTIONAL INFRINGEMENTS
AND PROVIDES FOR DAMAGES BOTH
STATUTORY AND ACTUAL
CIVIL AND CRIMINAL. UNAUTHORIZED
REPRODUCTION IN ANY FORM IS
STRICTLY PROHIBITED AND FORBIDDEN

DATE:
JAN. 19, 2018.
DRAWN THROUGH 3200 PECOS #1
JOB # JH118-024

PREPARED BY:
DRAFTING & DESIGN
AS-BUILT DRAWINGS FOR:
3201 N PECOS
MIDLAND TEXAS