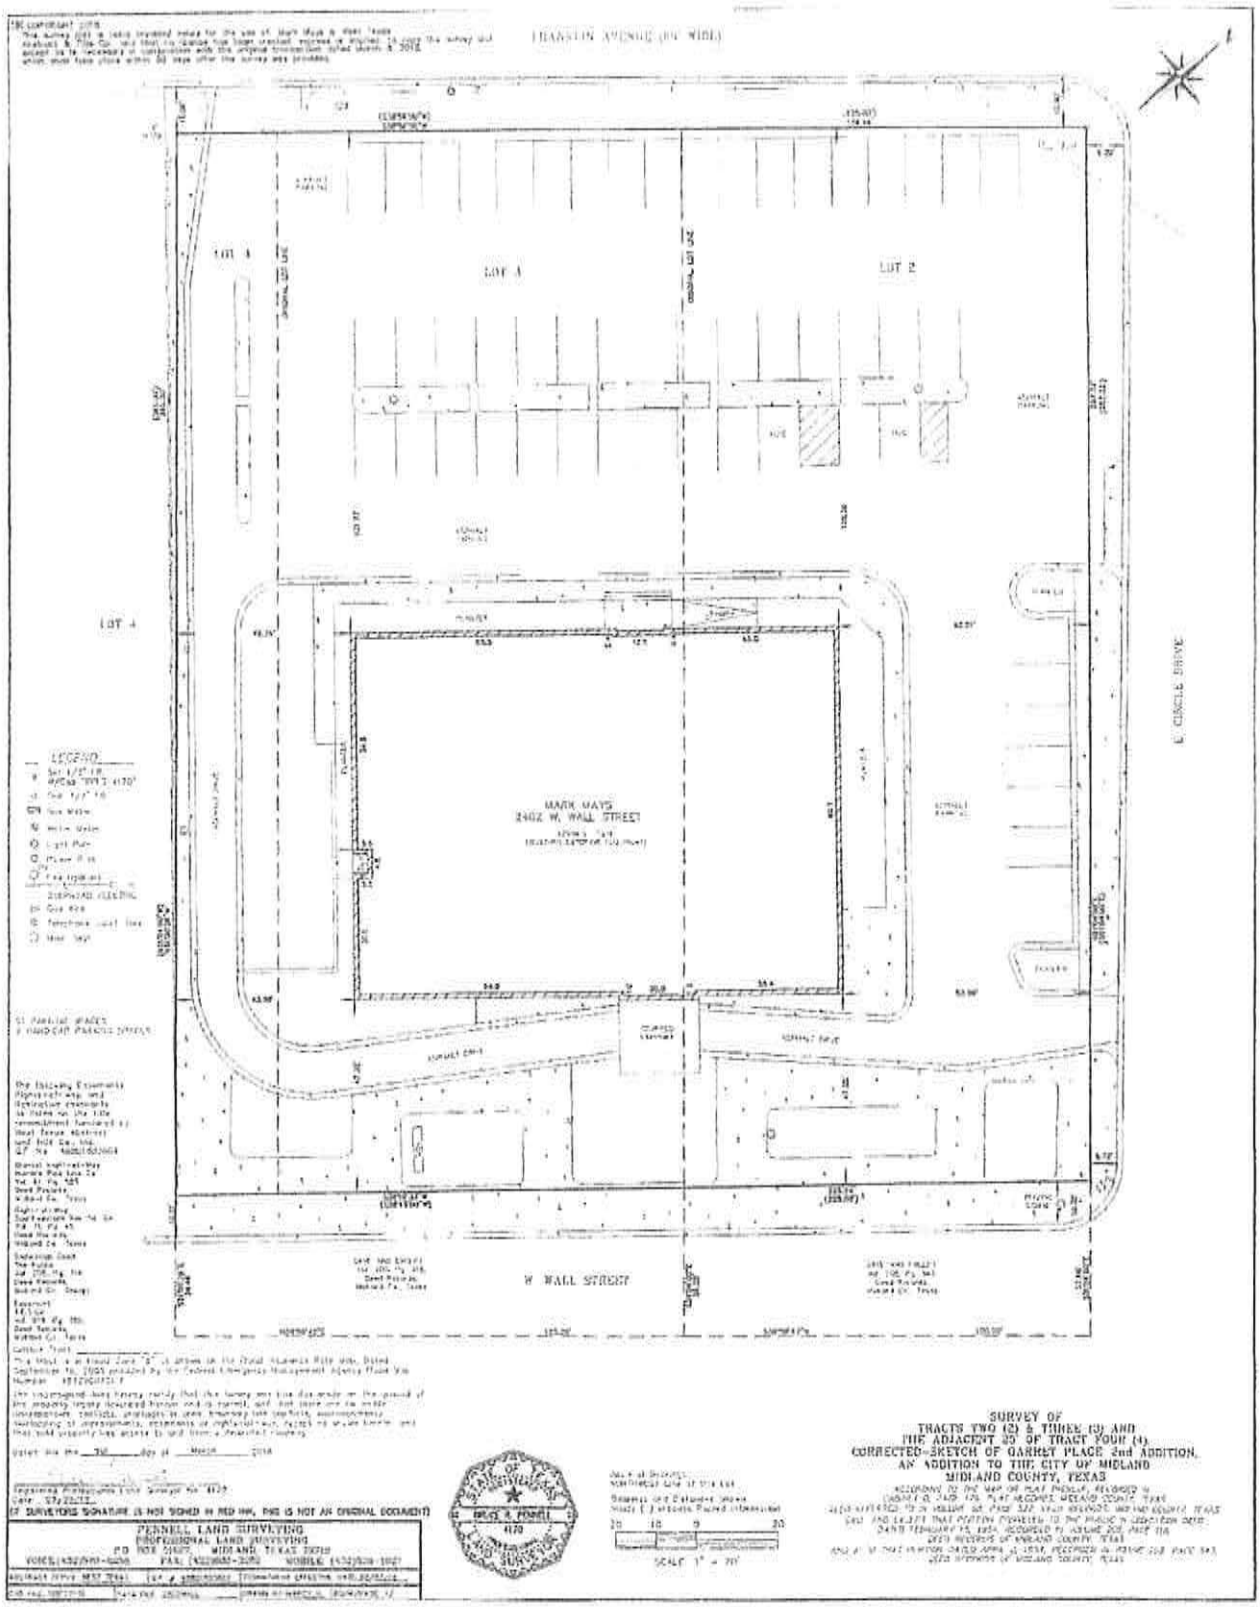

"AS BUILT" SURVEY